

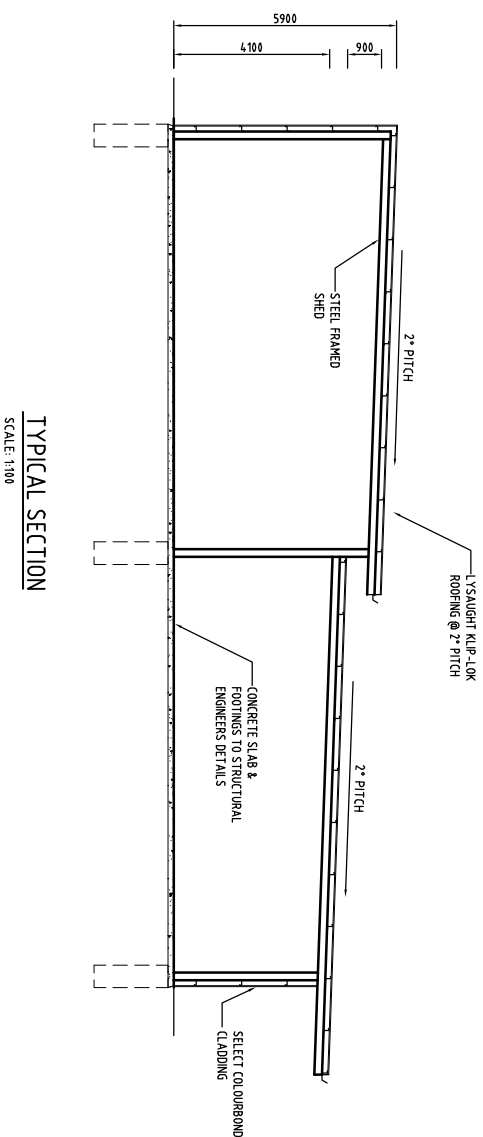


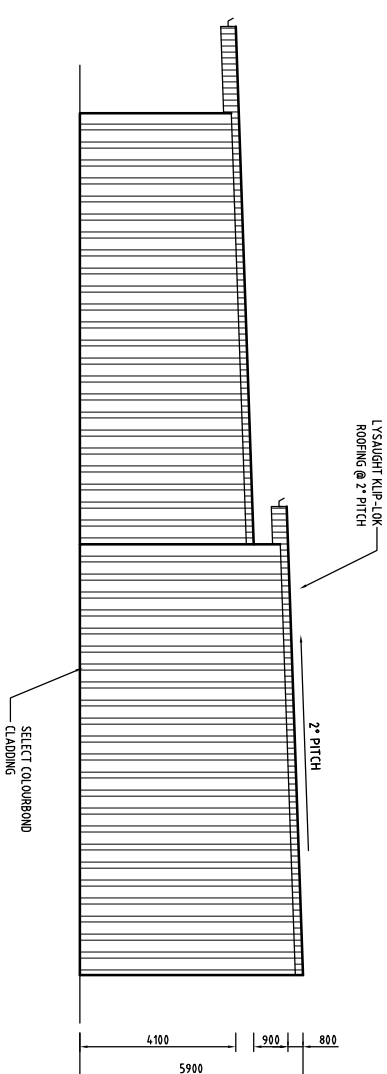

PRELIMINARY DRAWING
NOT TO BE USED FOR CONSTRUCTION PURPOSES

APPROVED:			DRAWING No.
	DATE:	AUGUST 2005	8767-C03
2	13.08.03	AS BUILT DRAWING	
1	20.08.05	D/A ISSUE	
A	07.08.05	ISSUE FOR COMMENT	
REV.	DATE	DESCRIPTION	
		APP	LM

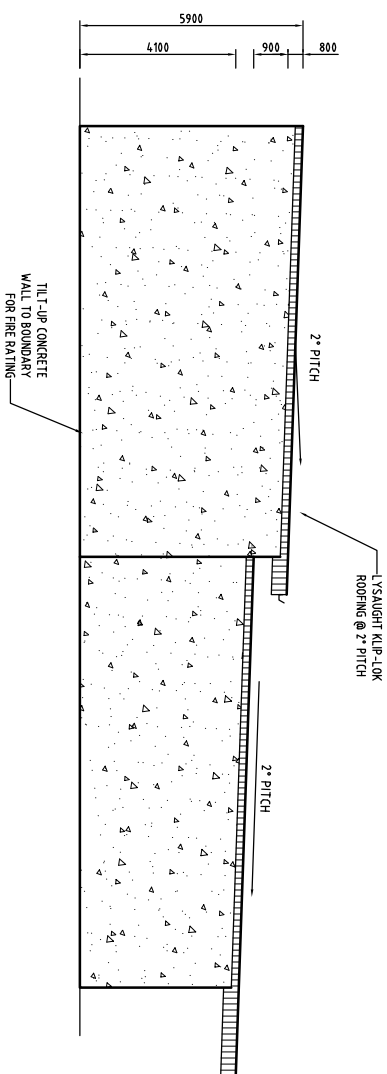

BARNSON

1201 008 342 623

**CIVIL, STRUCTURAL, GEOTECHNICAL
& ENVIRONMENTAL ENGINEERS,
INTERIORS TESTING LABORATORY,
RIVERVIEW BUSINESS PARK**

1/36 DARLING STREET, DUBBO NSW 2830
PH: 02 68842944 FAX: 02 68845857
EMAIL: barnson@barnson.com.au

WEBSITE: www.barnson.com.au



**EQUAL
HOUSING
OPPORTUNITY**

CLIENT:	Mr S & Mrs TA BOX
PROJECT:	PROPOSED INDUSTRIAL REDEVELOPMENT, 33-37 INGLIS STREET, MUDGEE, N.S.W
TITLE:	PROPOSED ELEVATIONS, TYPICAL SECTION & HYDRAULIC DETAILS